




Copyright 2005 Philip Aaron Lacy, Architect. All rights reserved. No portion of this document may be reproduced without written permission.

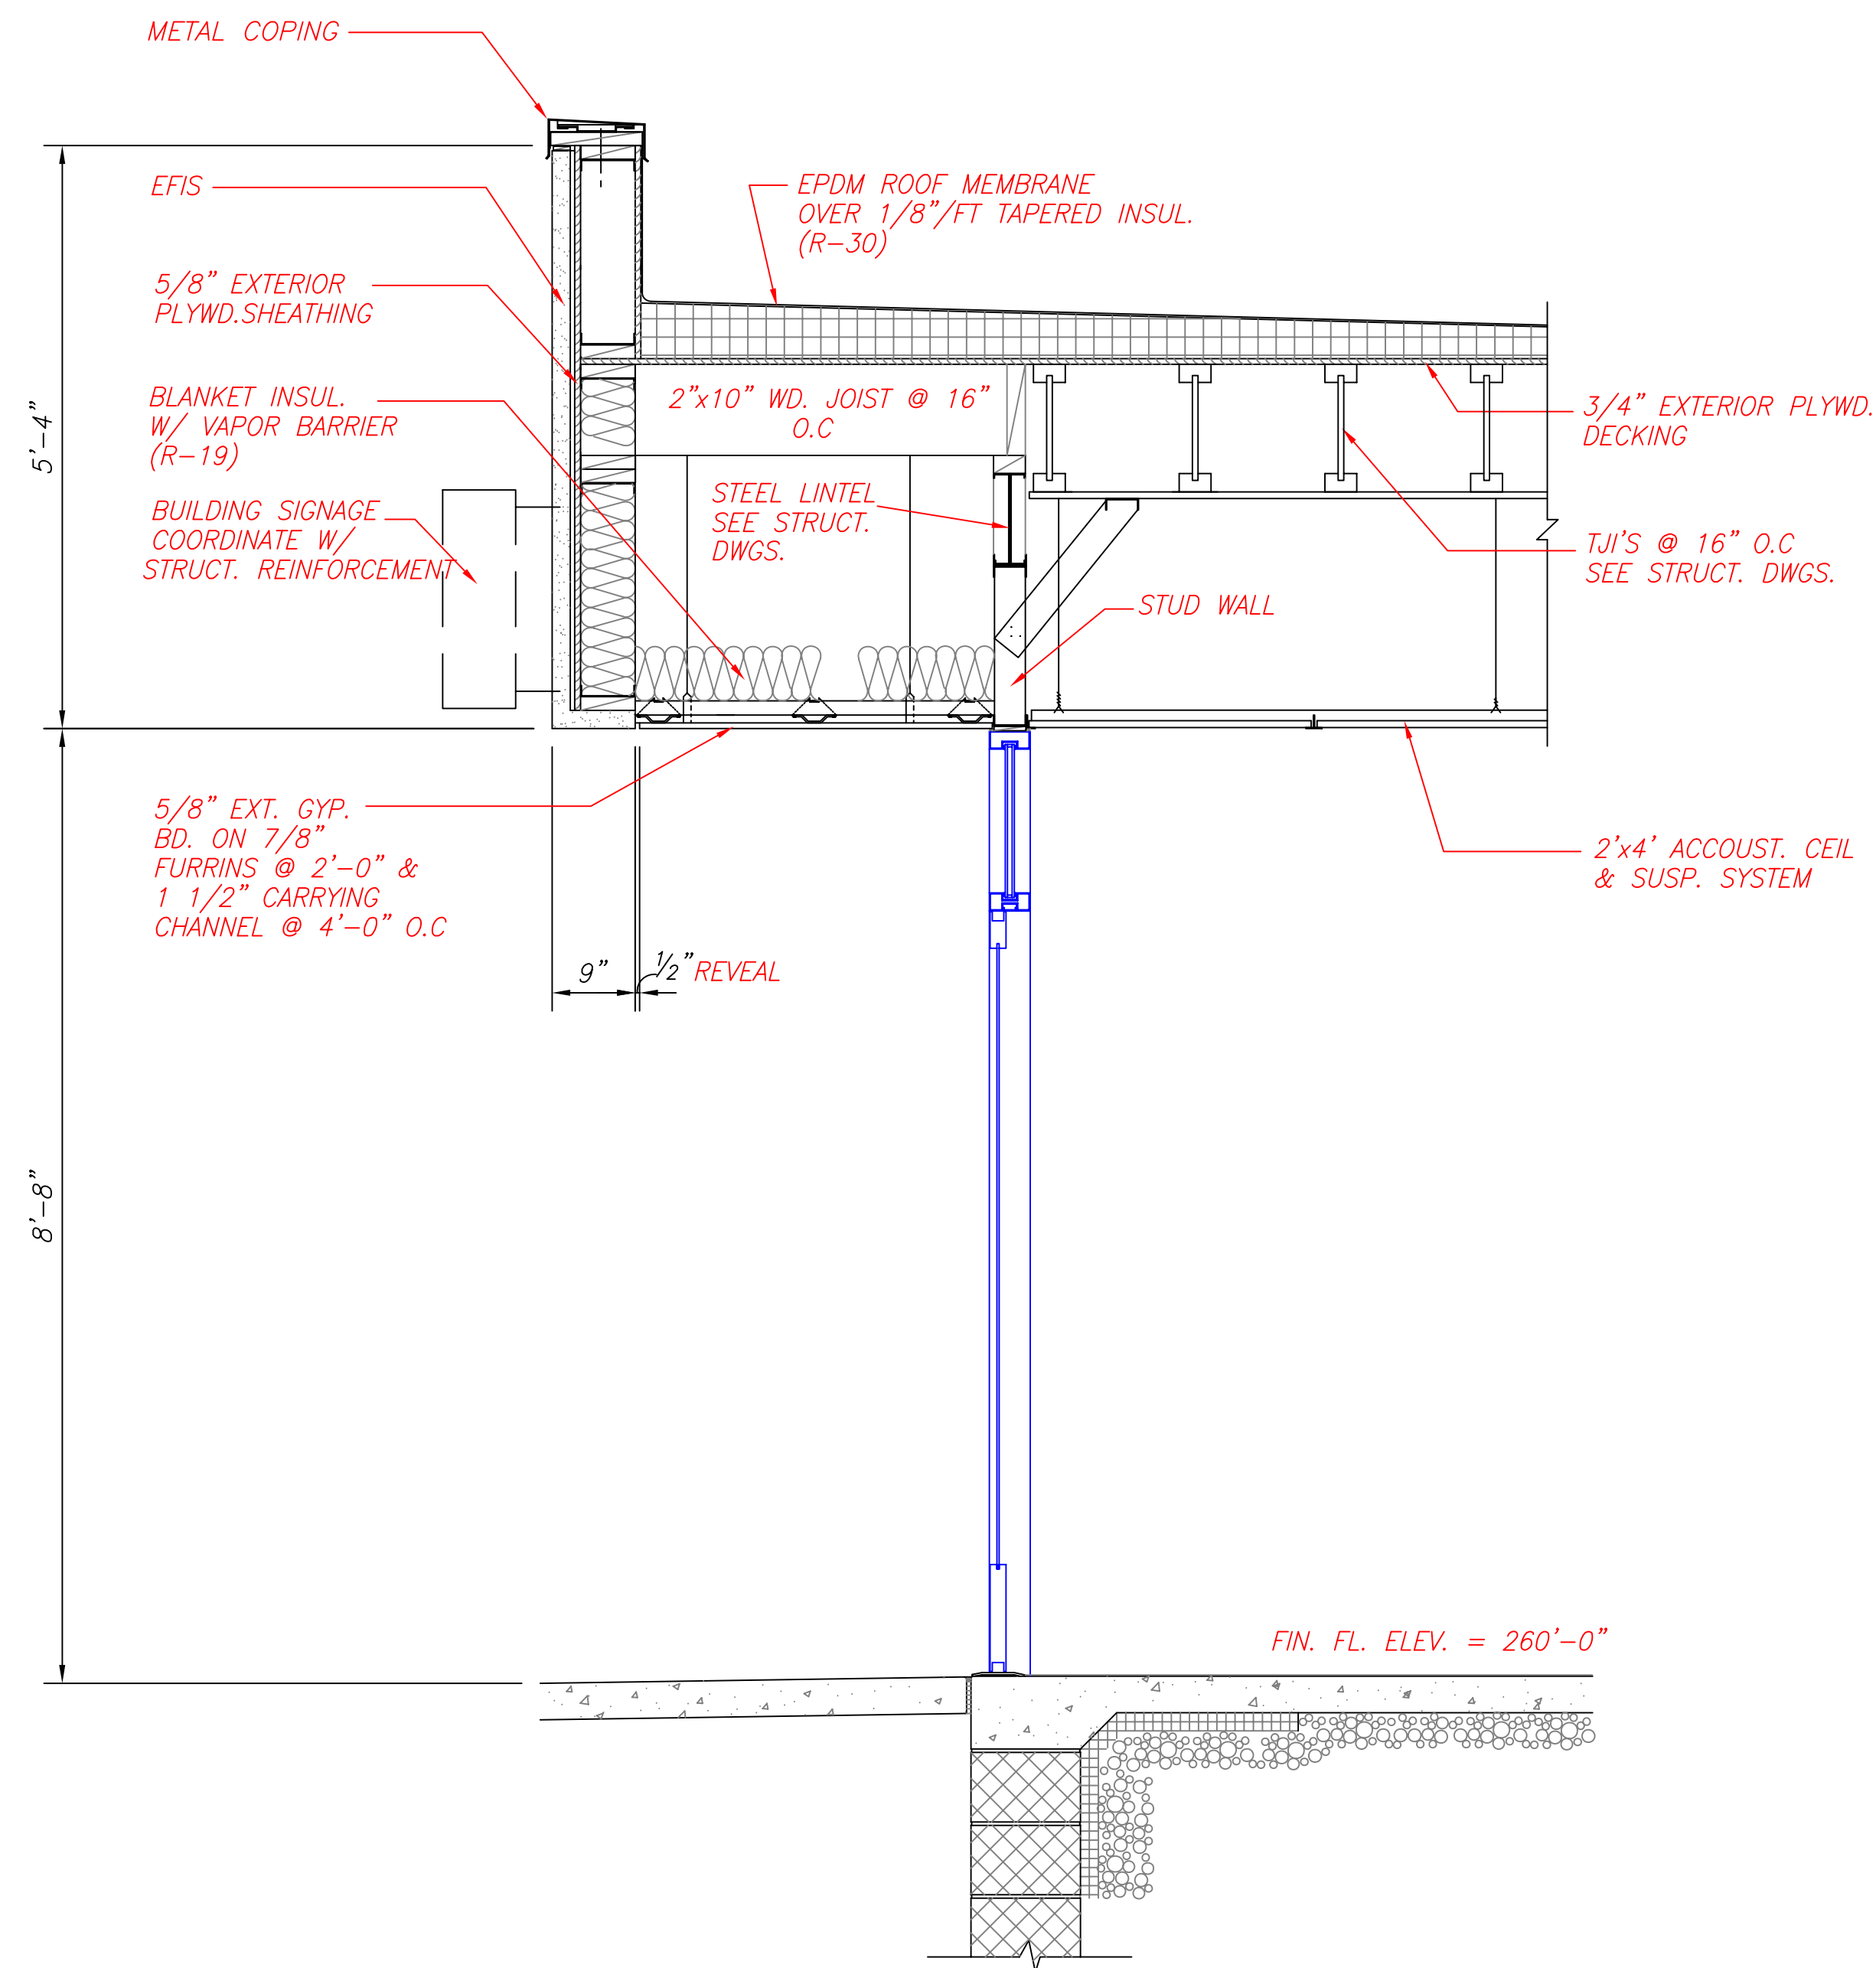

WALL SECTION 1
SCALE: 3/4"=1'-0"
A-7

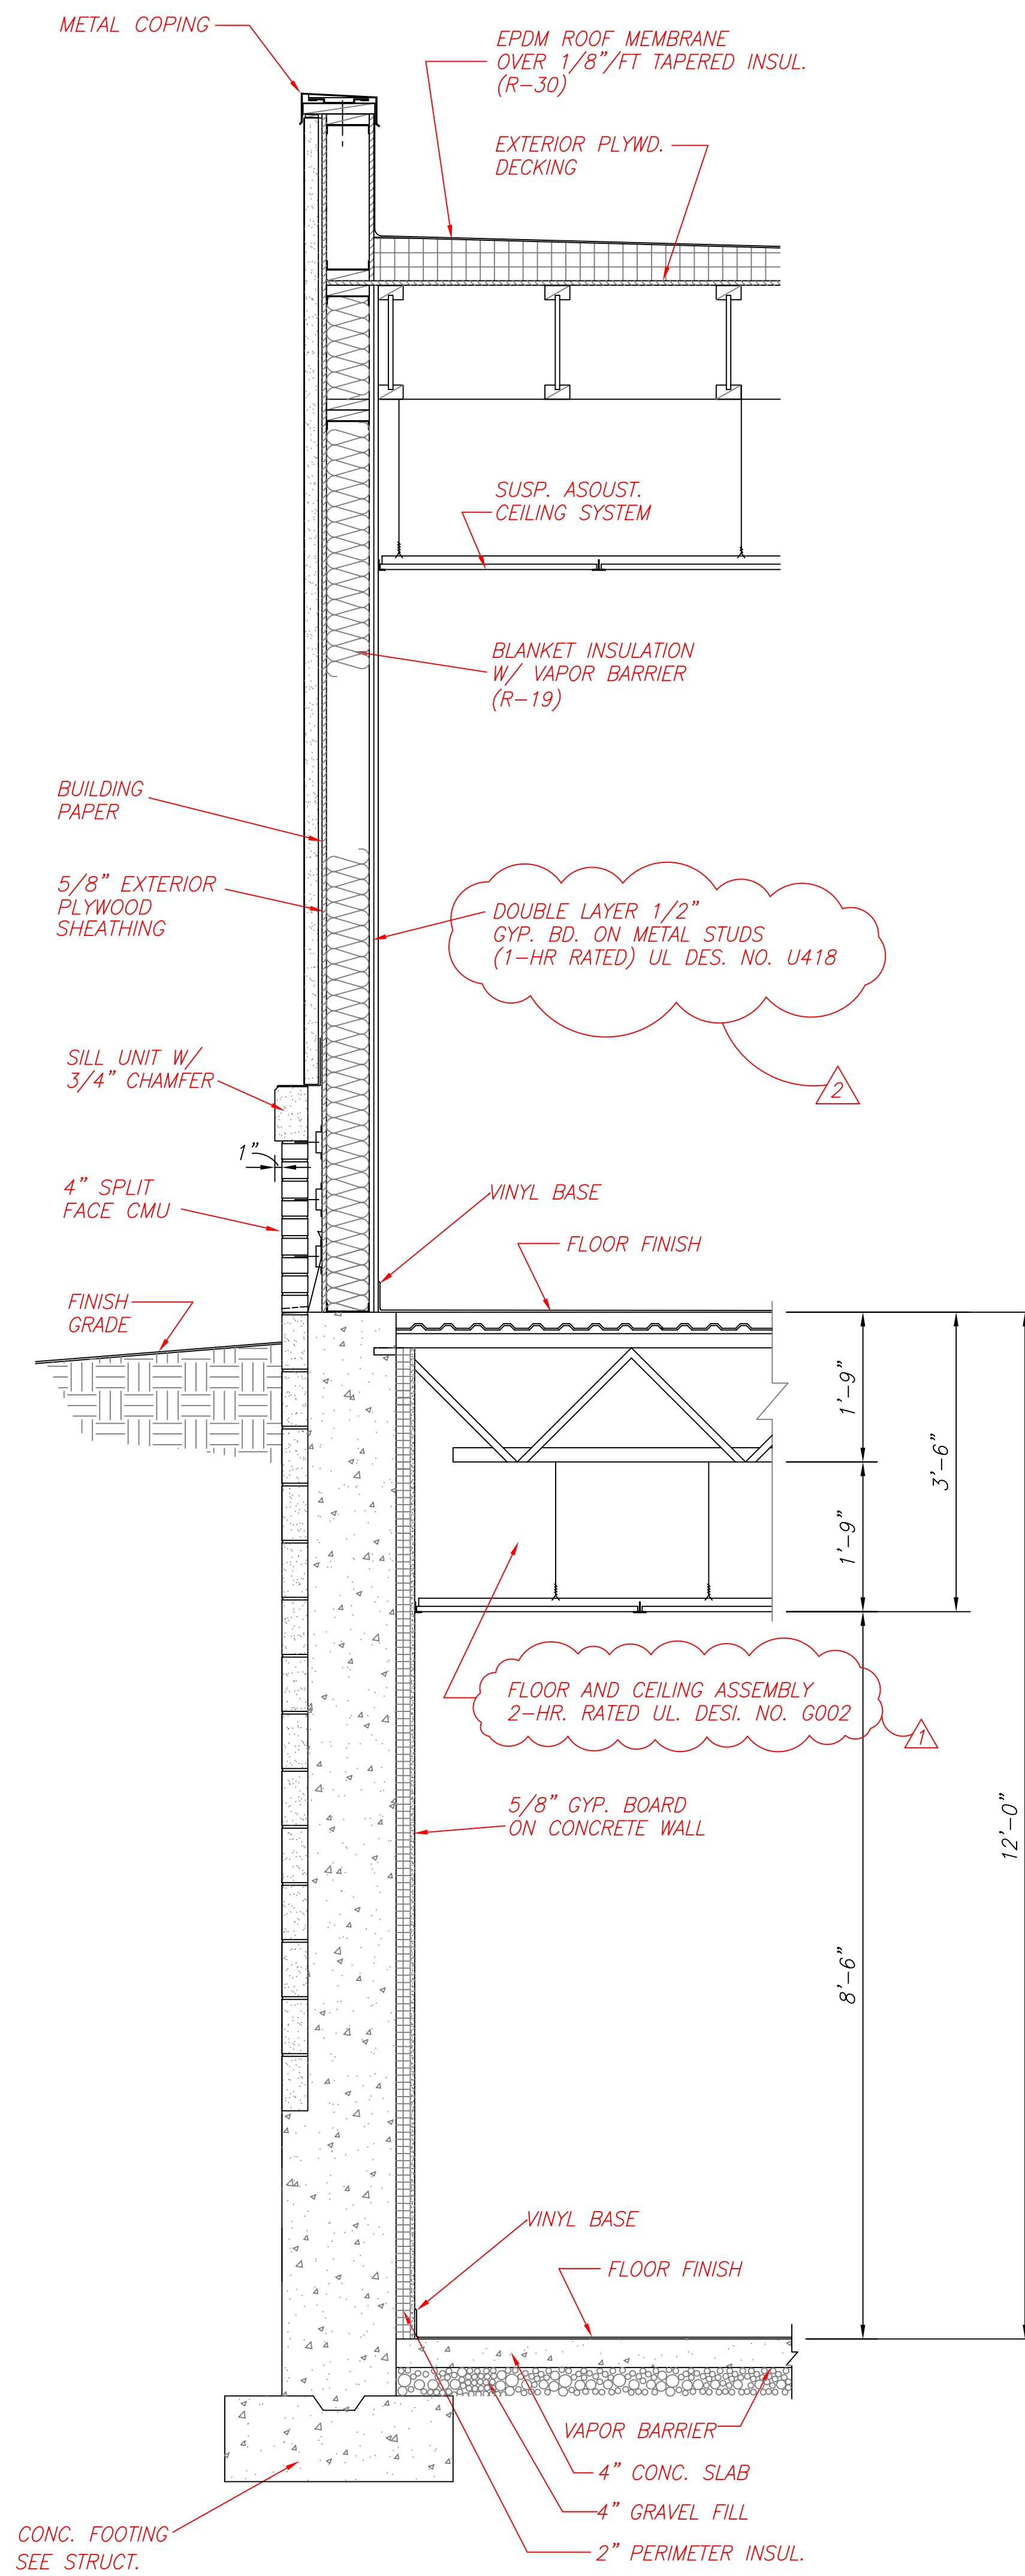

WALL SECTION 2
SCALE: 3/4"=1'-0"
A-7

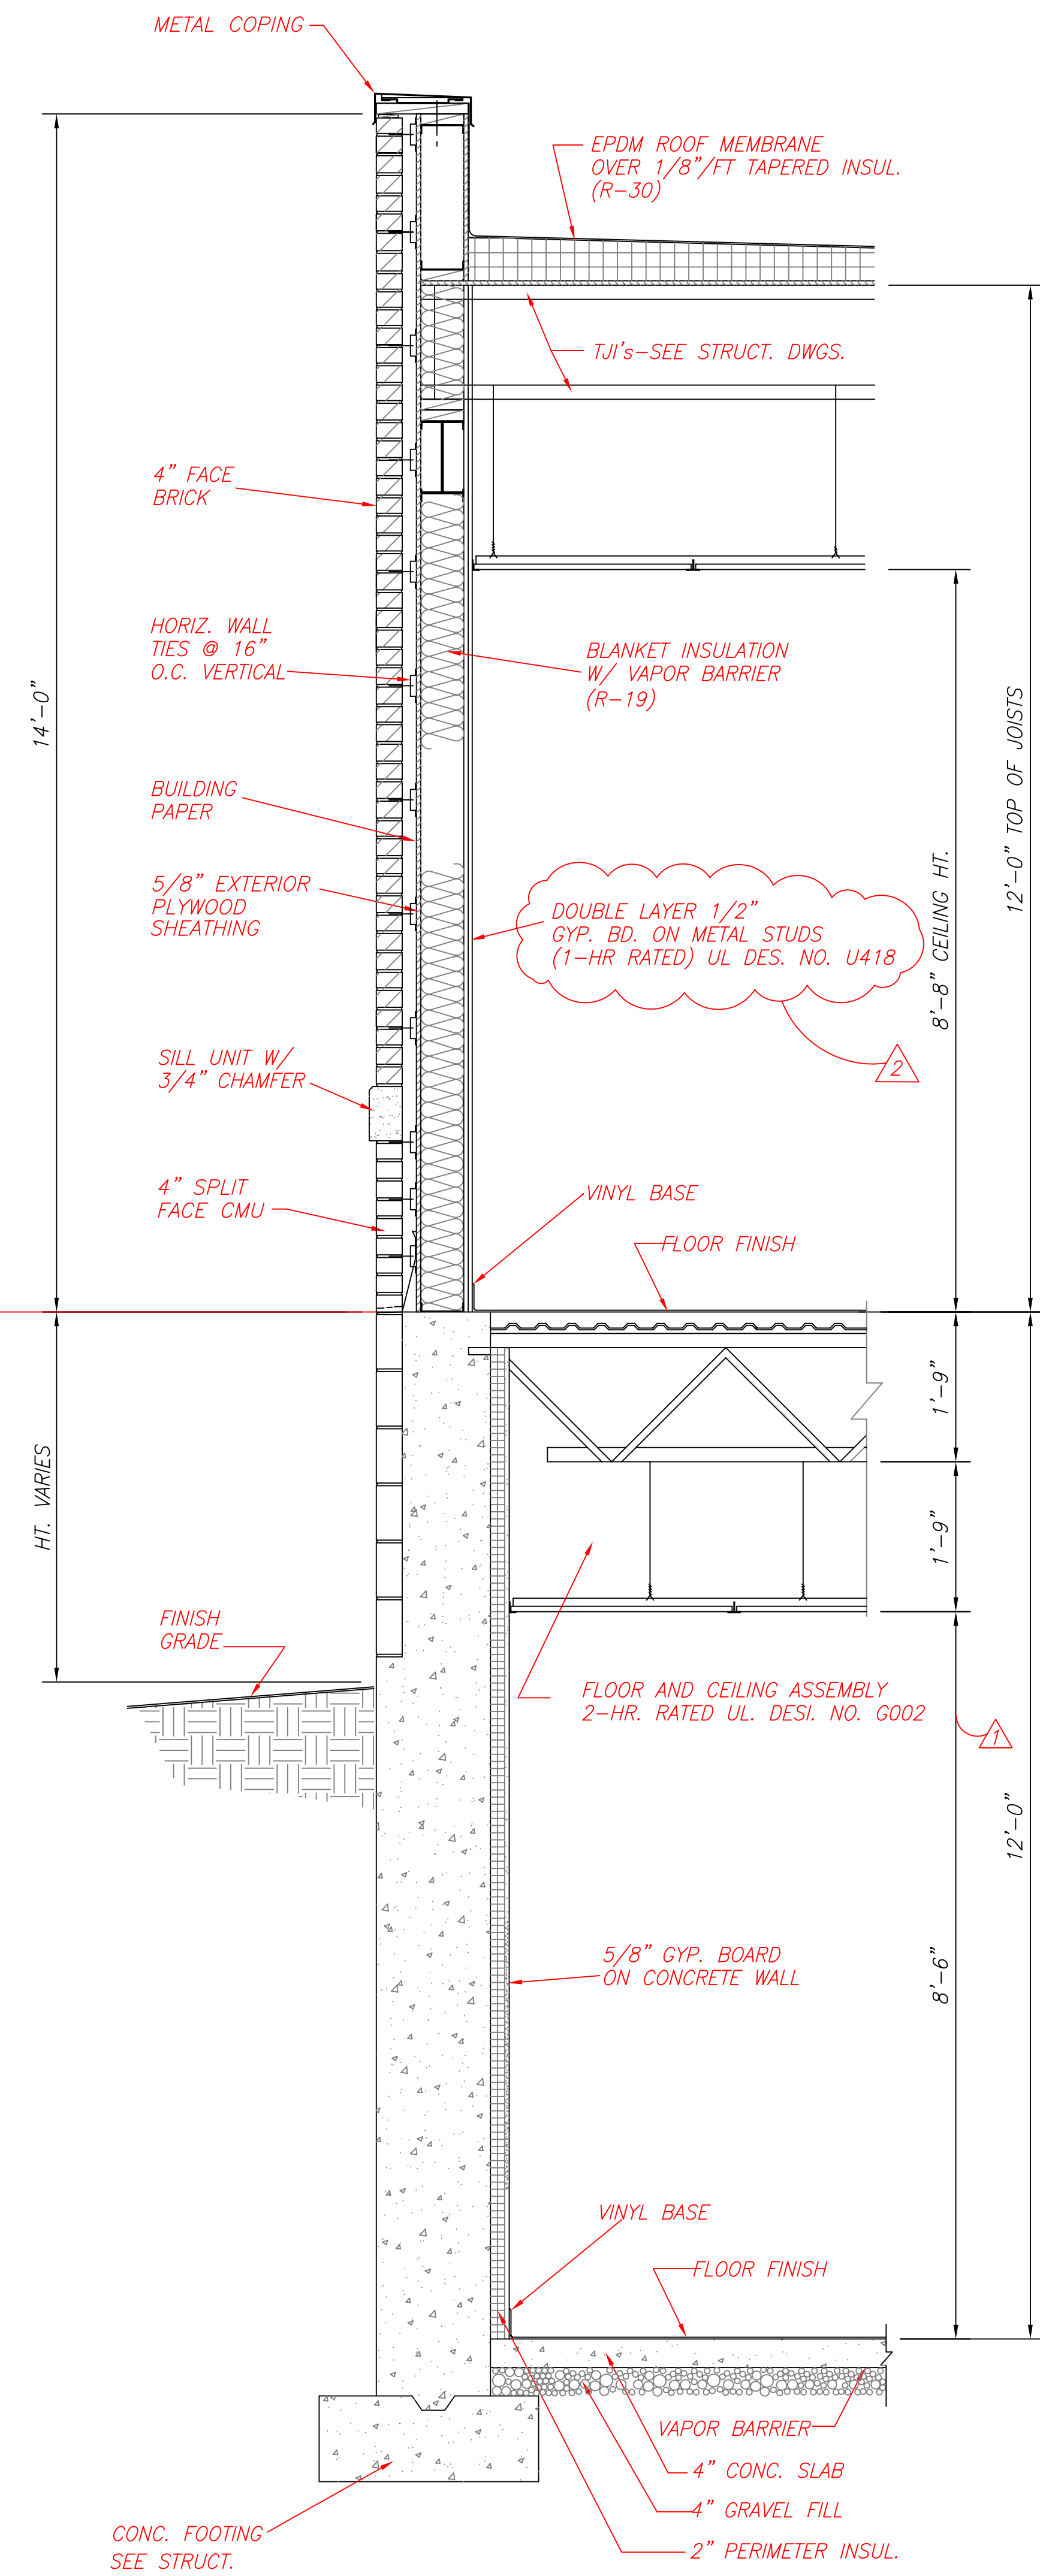

WALL SECTION 3
SCALE: 3/4"=1'-0"
A-7

Date:	1-14-08
Revisions:	COUNTY REVIEW COMMENTS 6-4-08
	COUNTY REVIEW COMMENTS

Consultants:
WARDER & ASSOCIATES, INC.
CHURCH EXPANSION SPECIALIST
8016 CHURCH LANE, PERRY, ROAD
CLINTON, MARYLAND 20734
PHONE: 301-868-5900

Certification:

Project Title:
BETH SHALOM A.M.E. ZION CHURCH
2501 RITCHIE ROAD
DISTRICT HEIGHTS, MARYLAND 20735
WALL SECTIONS

Philip Aaron Lacy, Architects
6188 Oxon Hill Road, Suite 303
Oxon Hill, Maryland 20745
Phone: 301-567-8223

Date: DEC. 1, 2005
Scale: 3/4"=1'-0"
Drawn: FCB
Checked: PAL
File No. BETH_A07

Drawing No.
A-7
of