
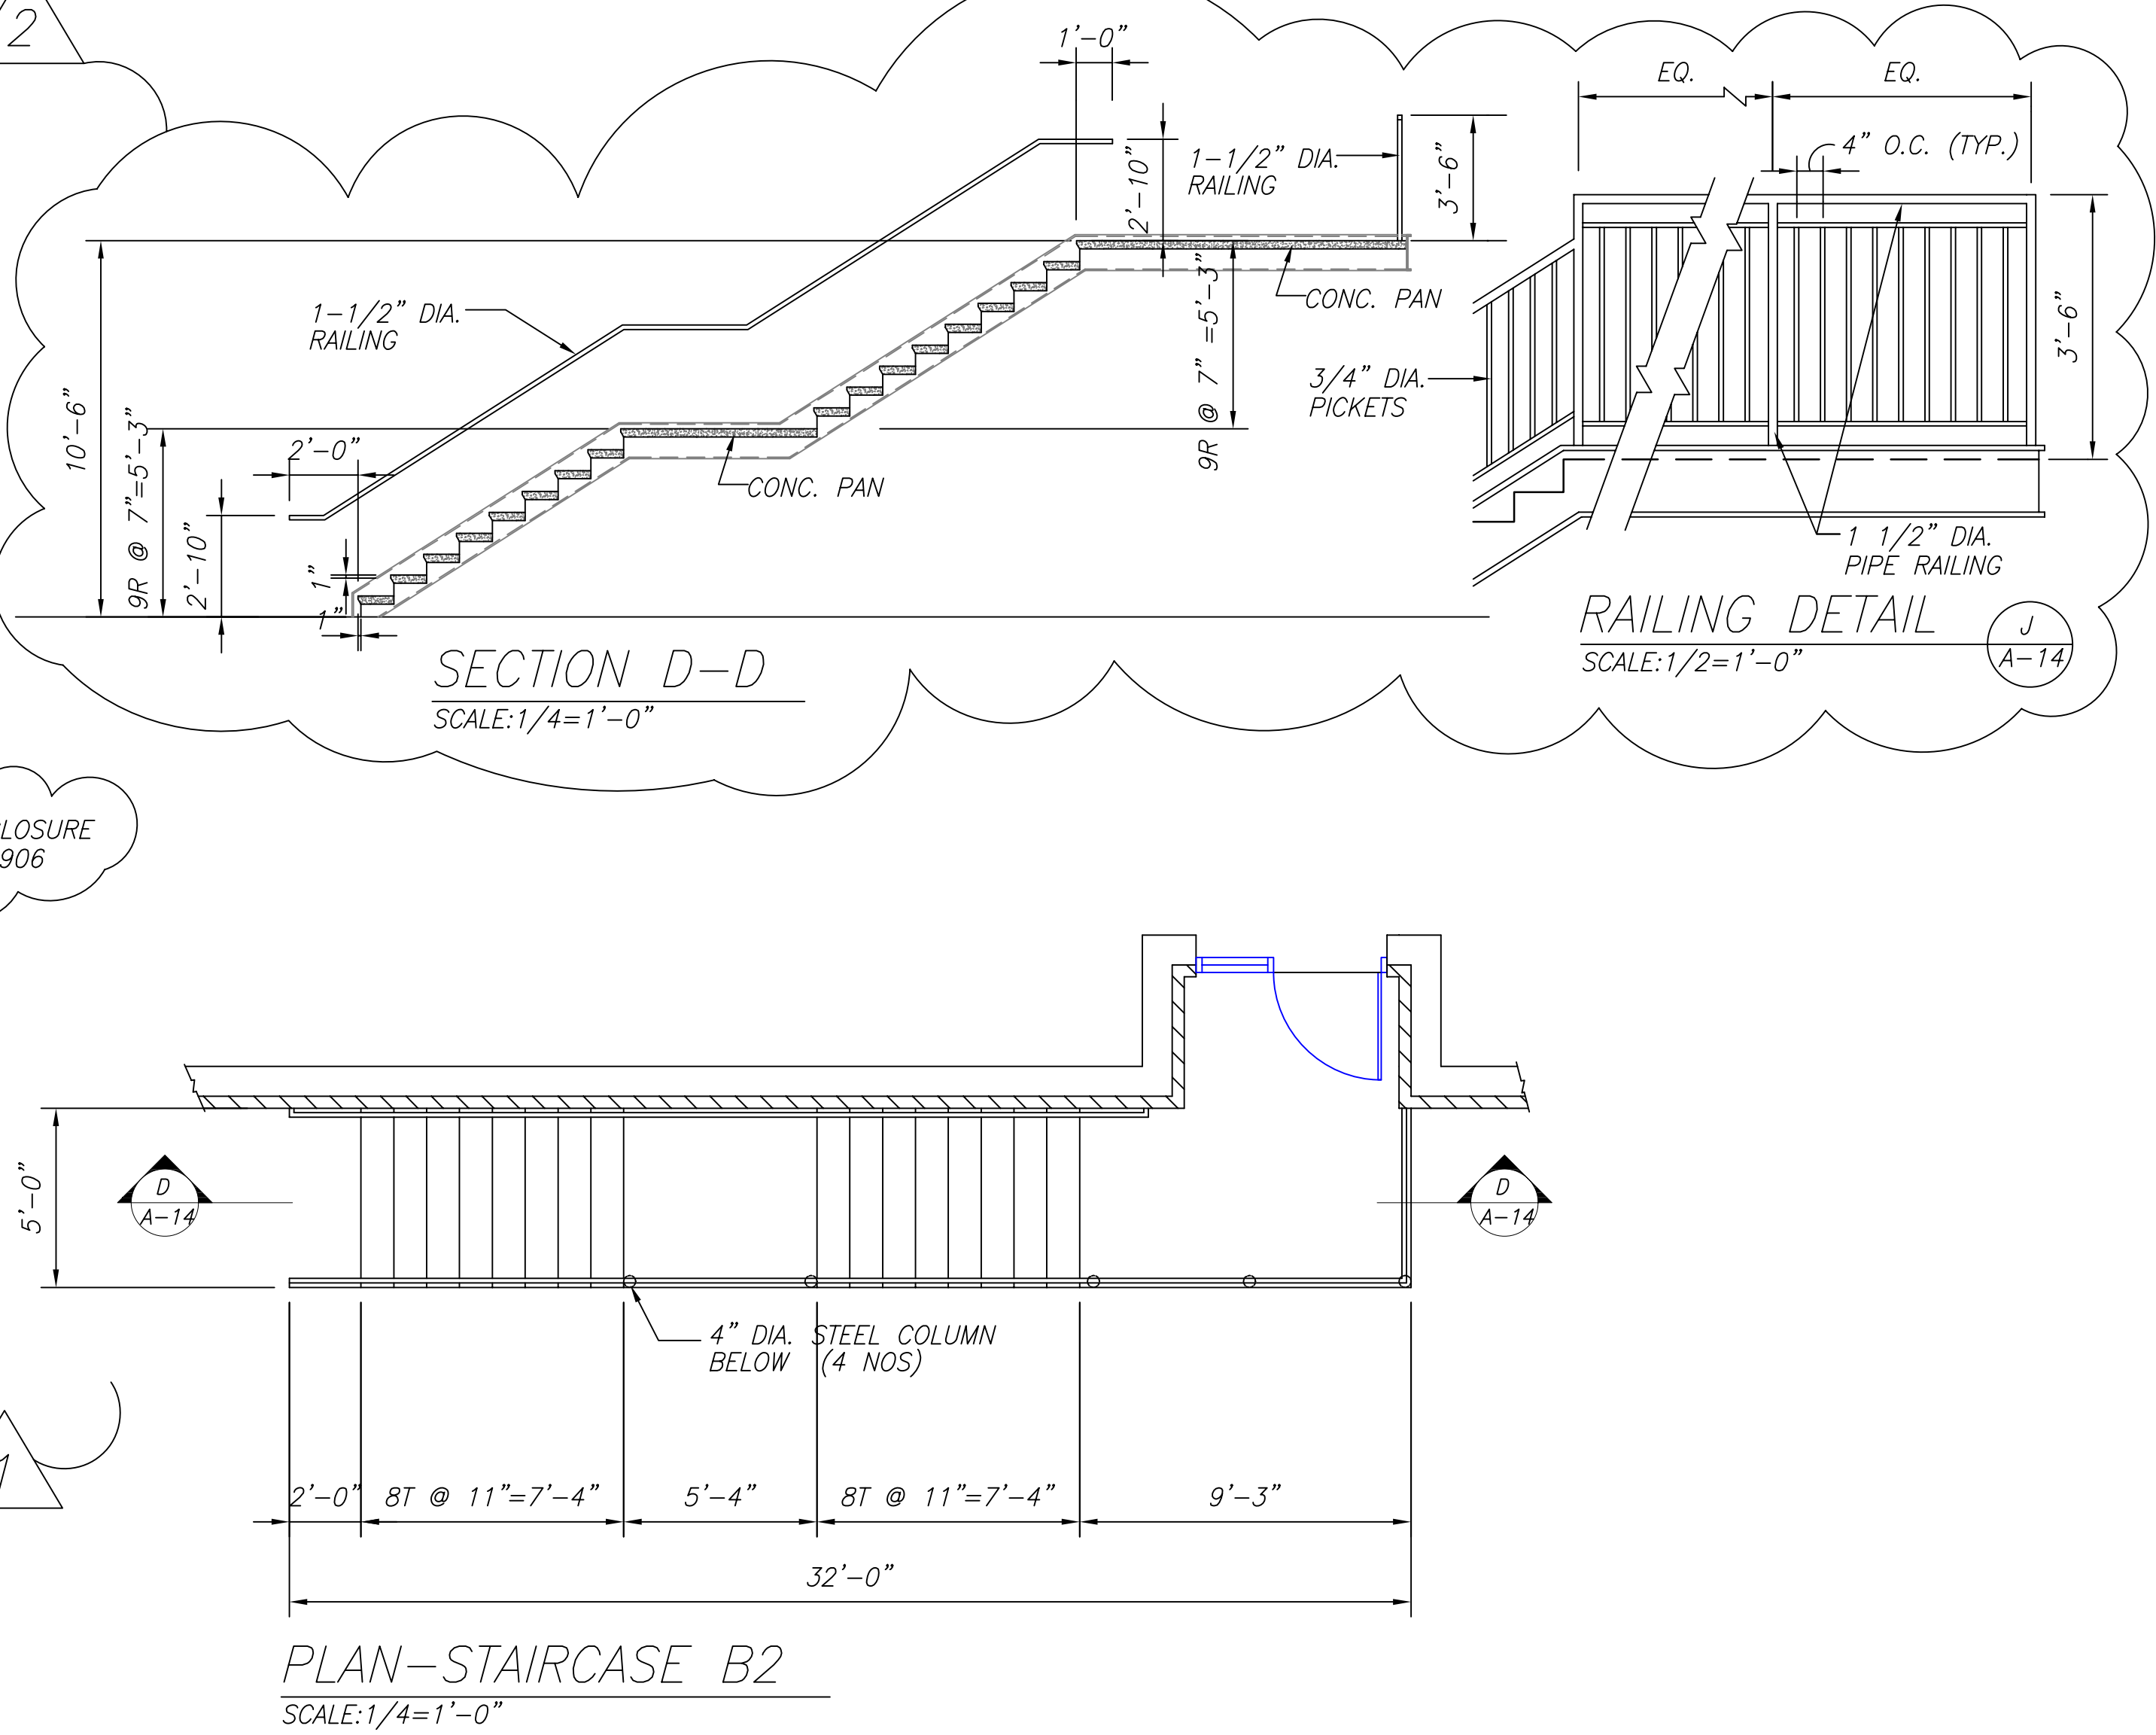
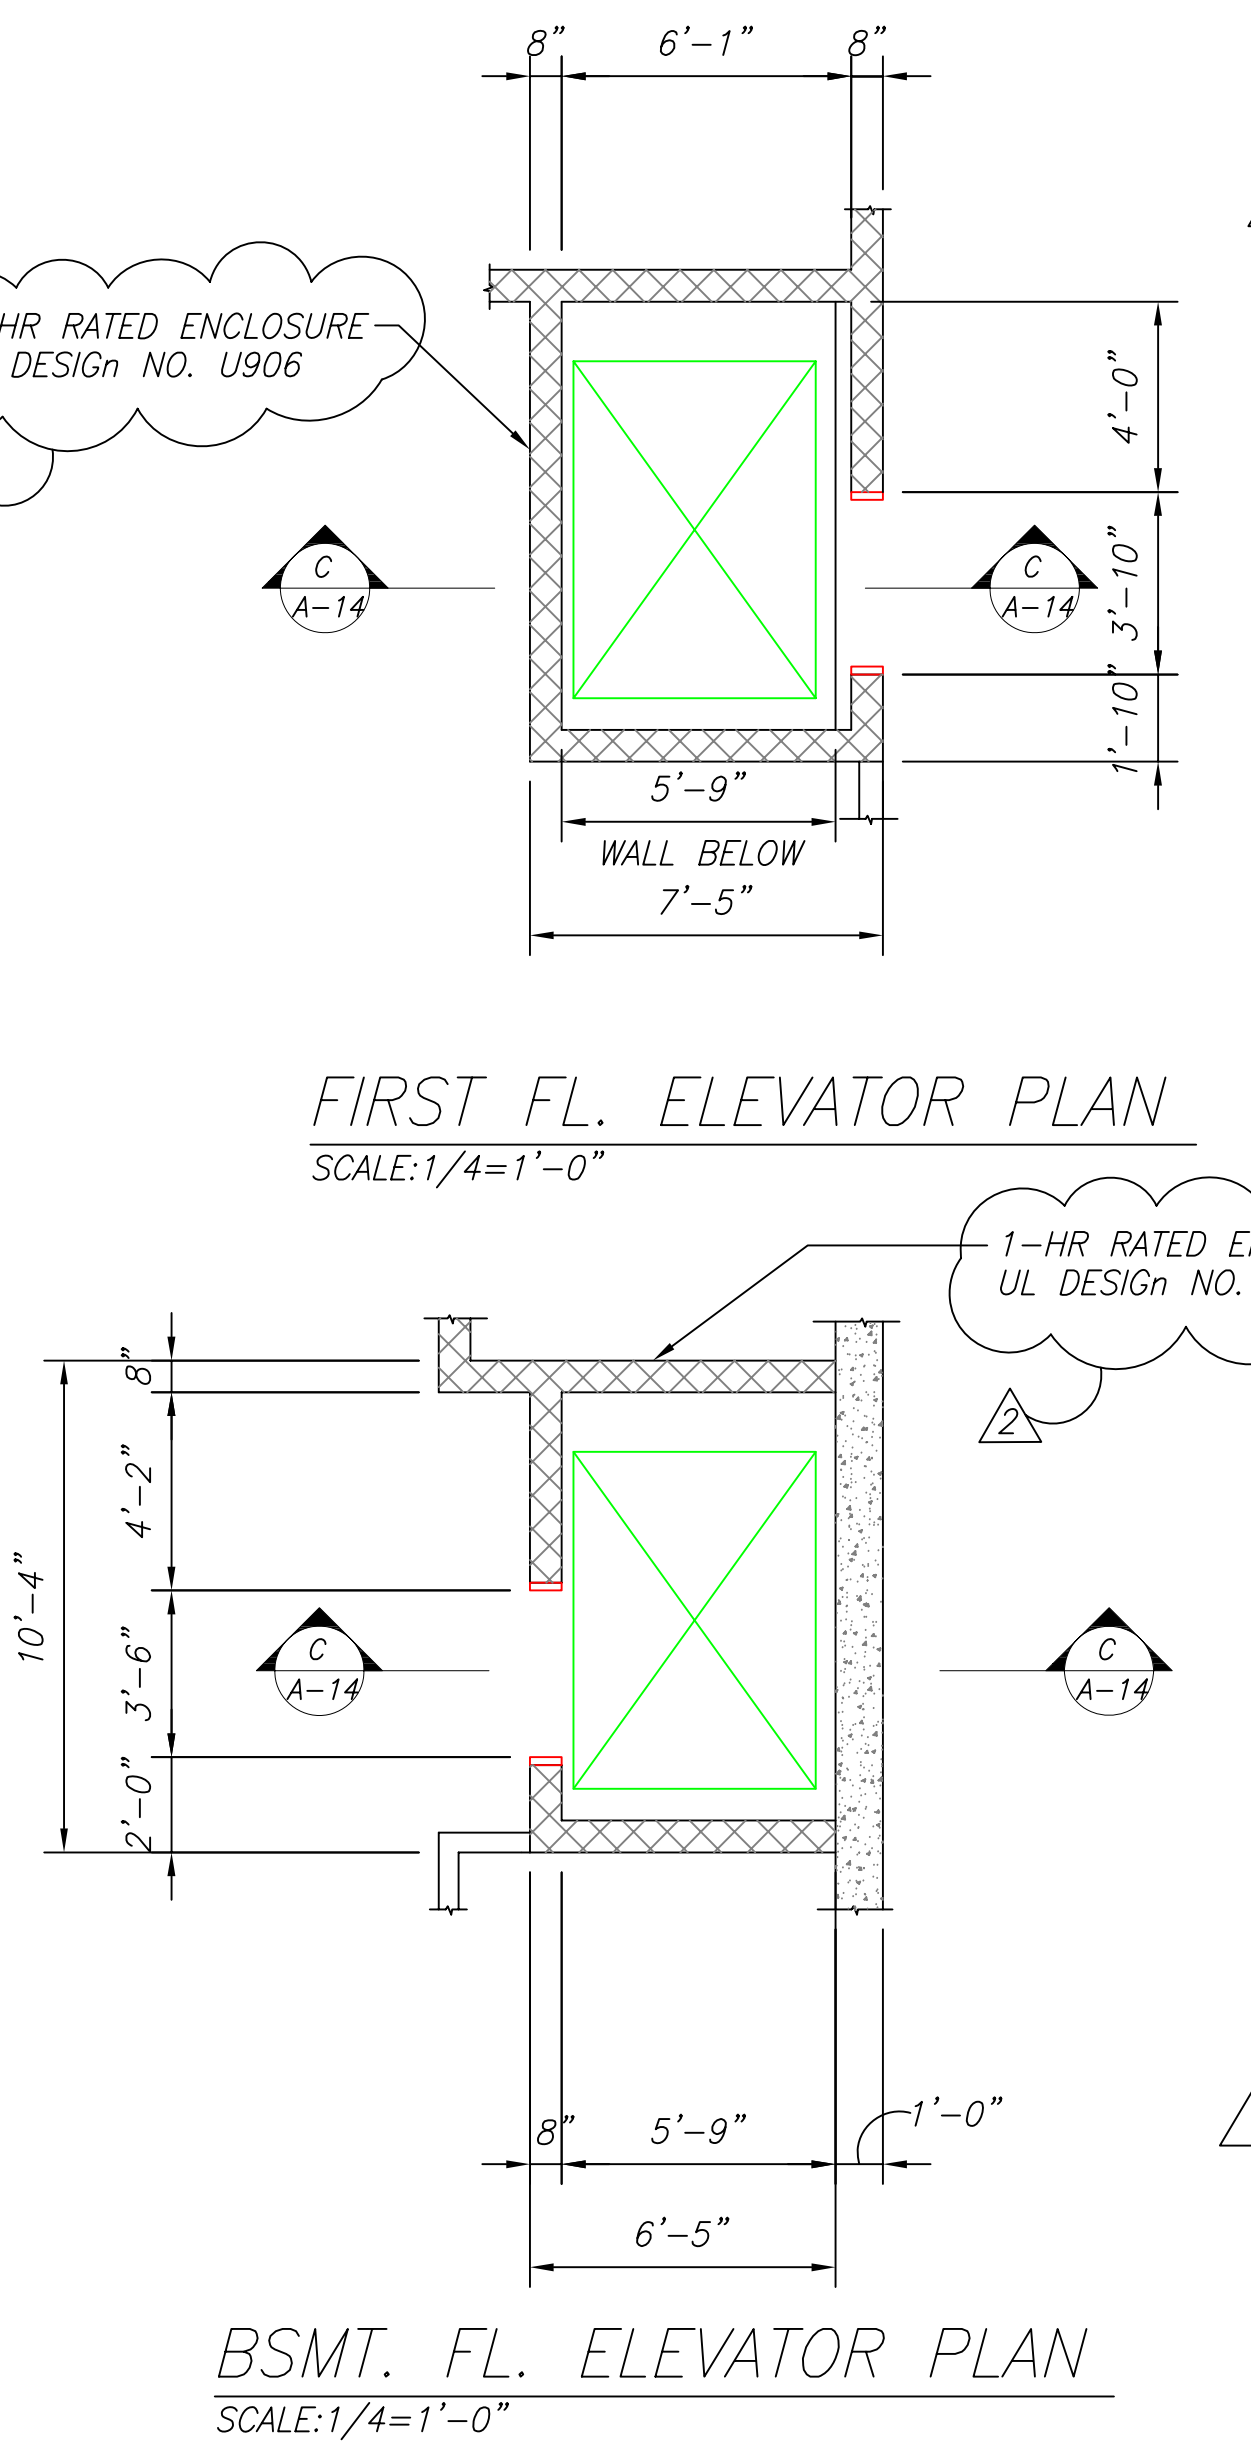
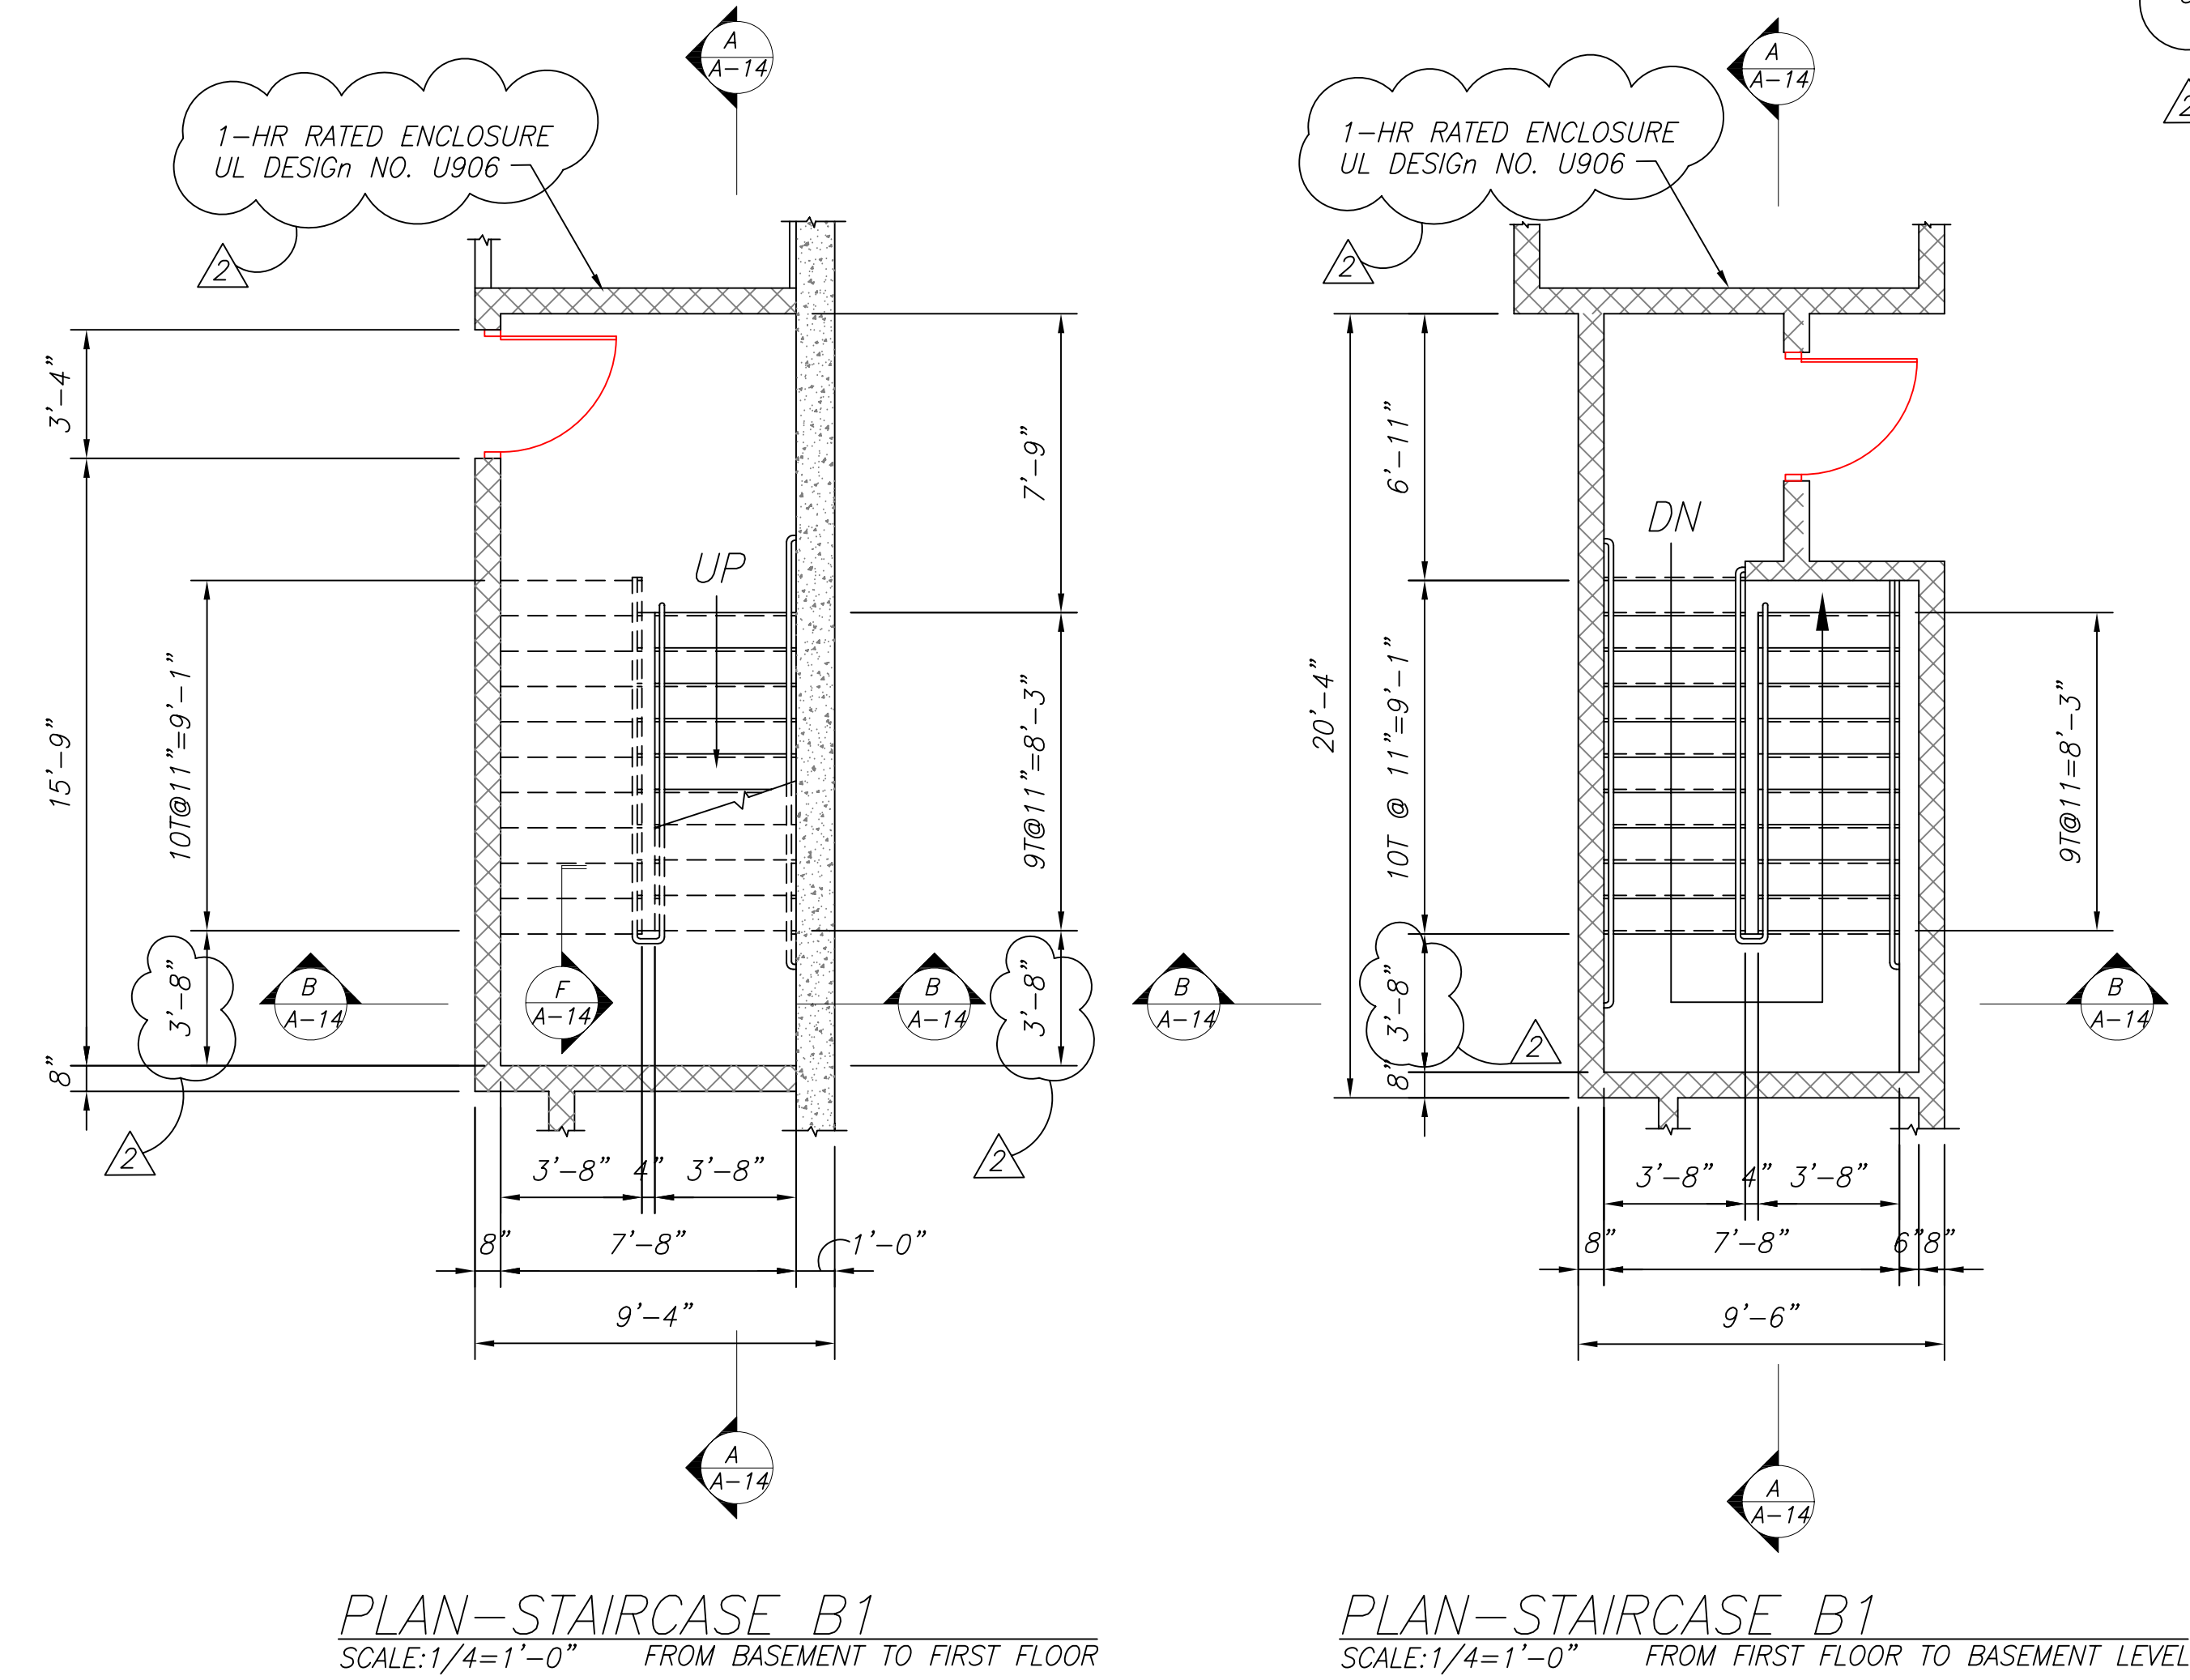
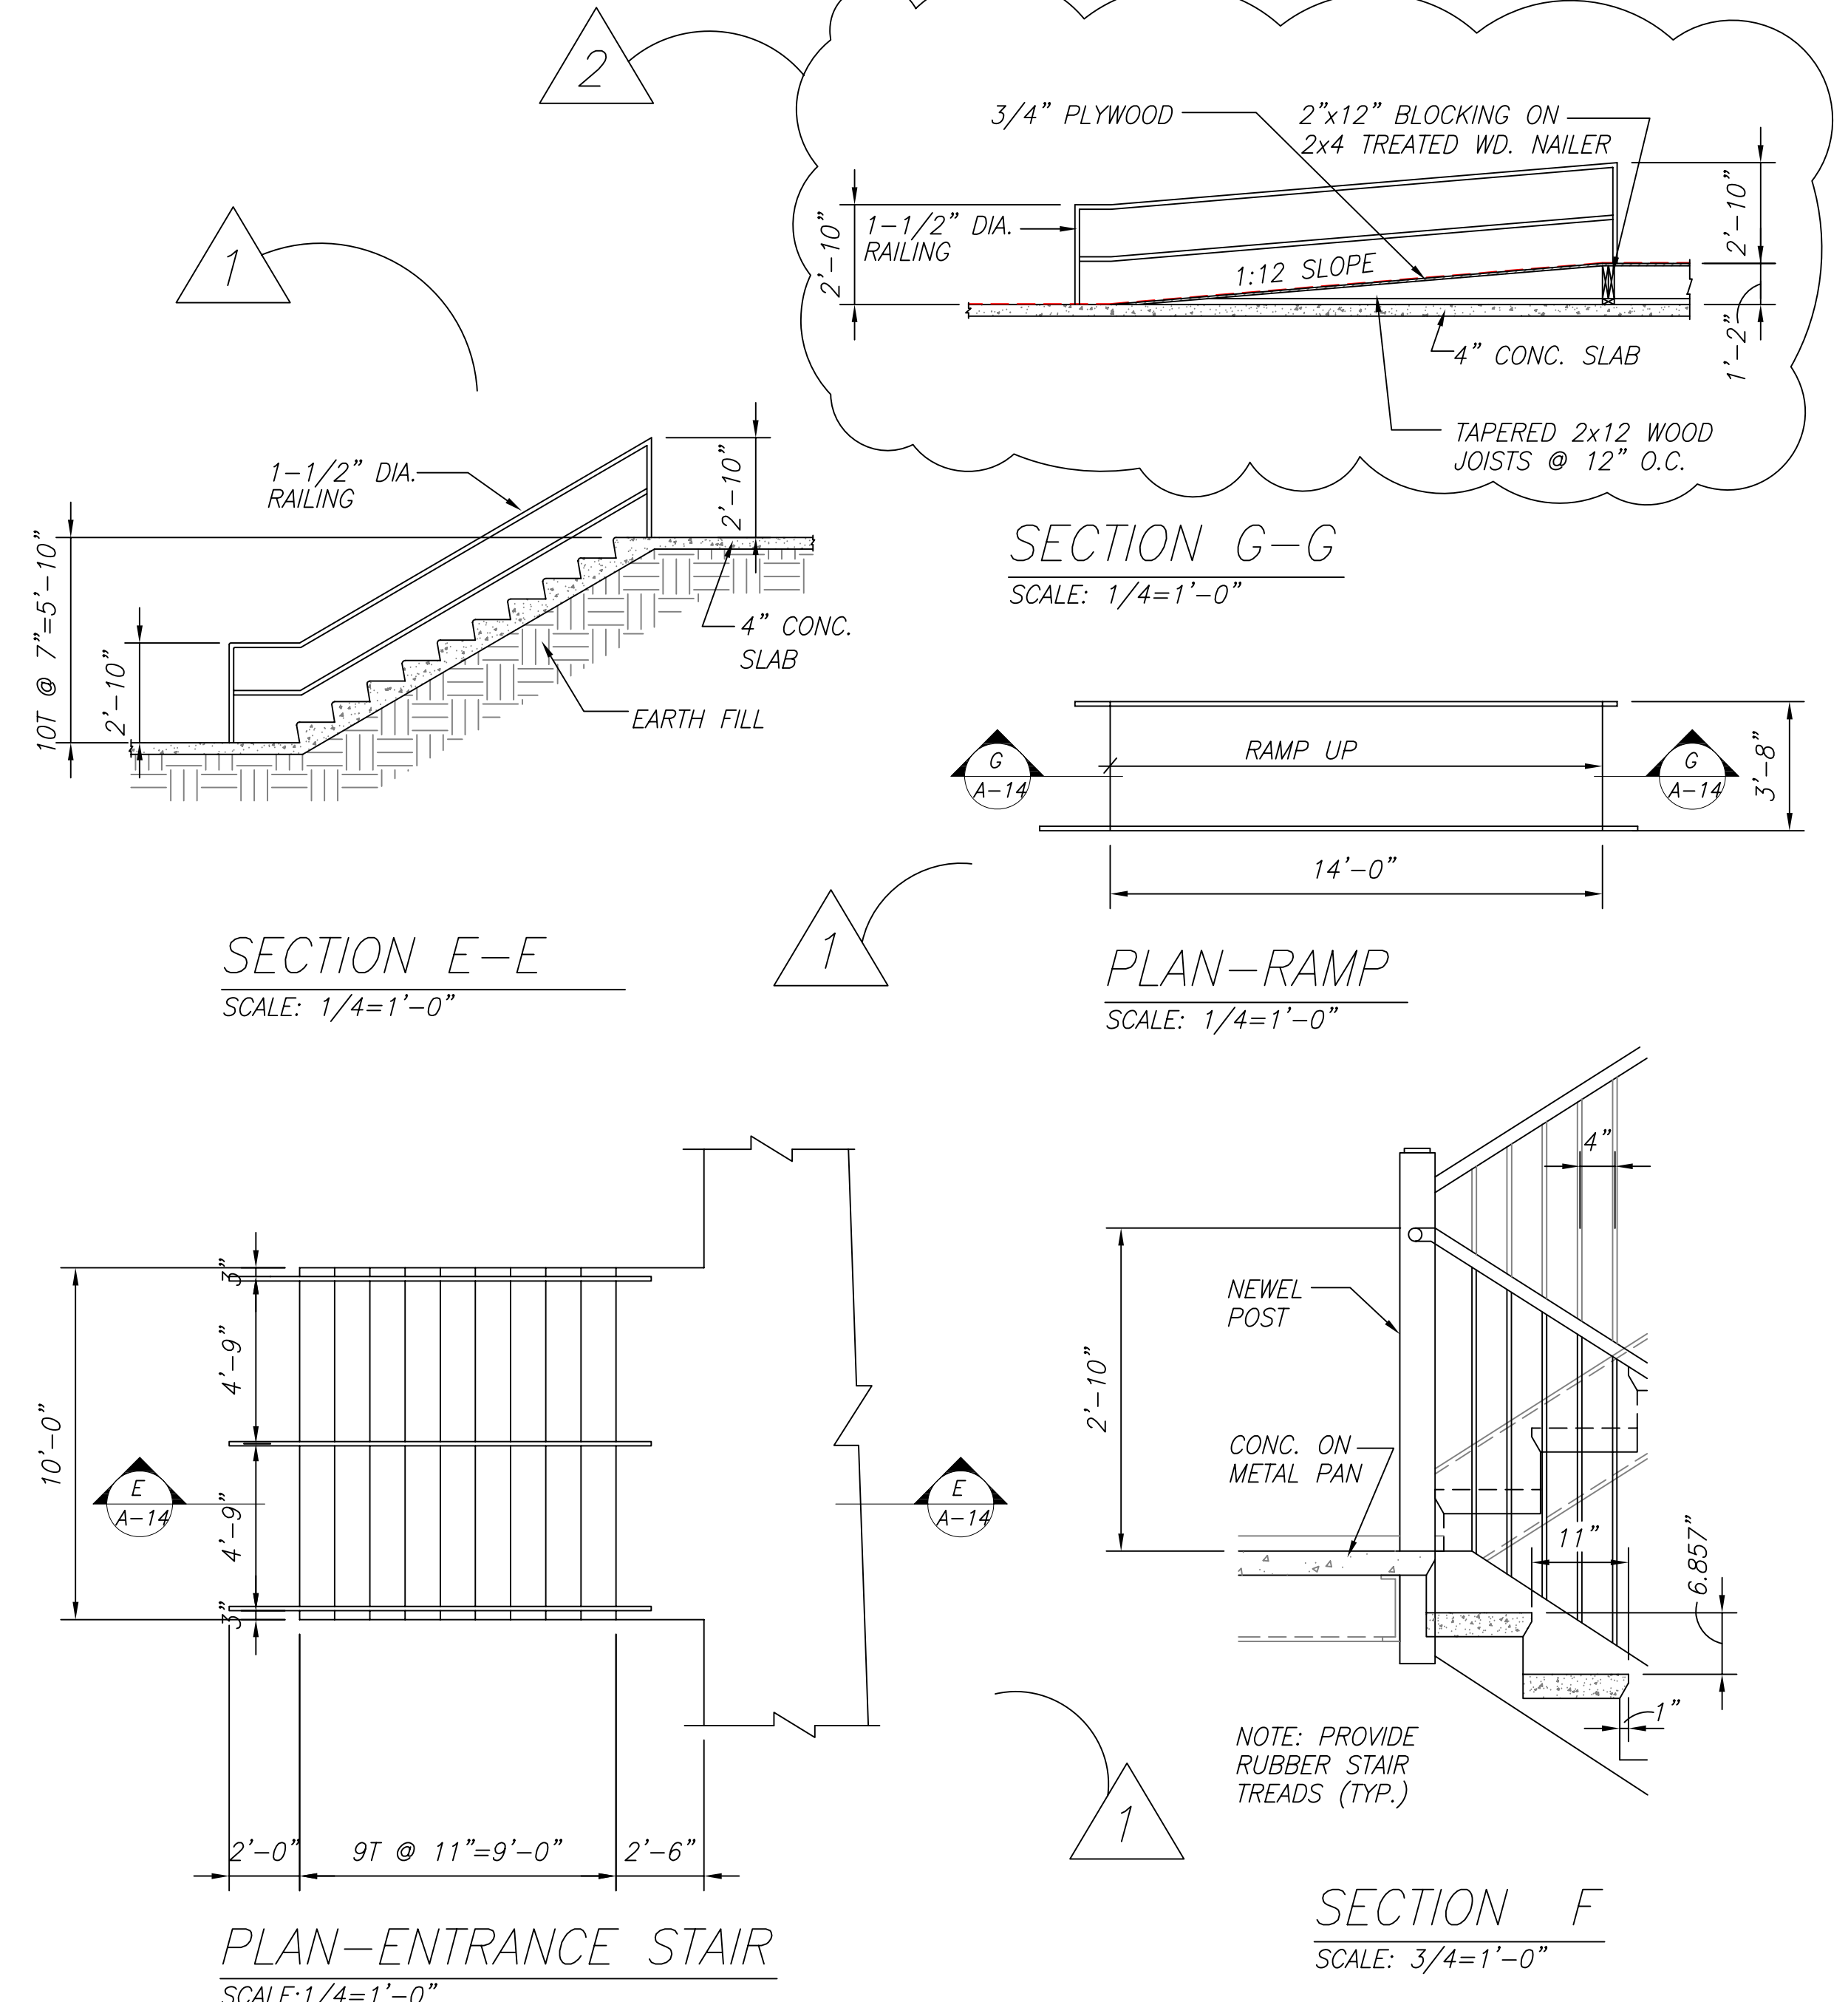
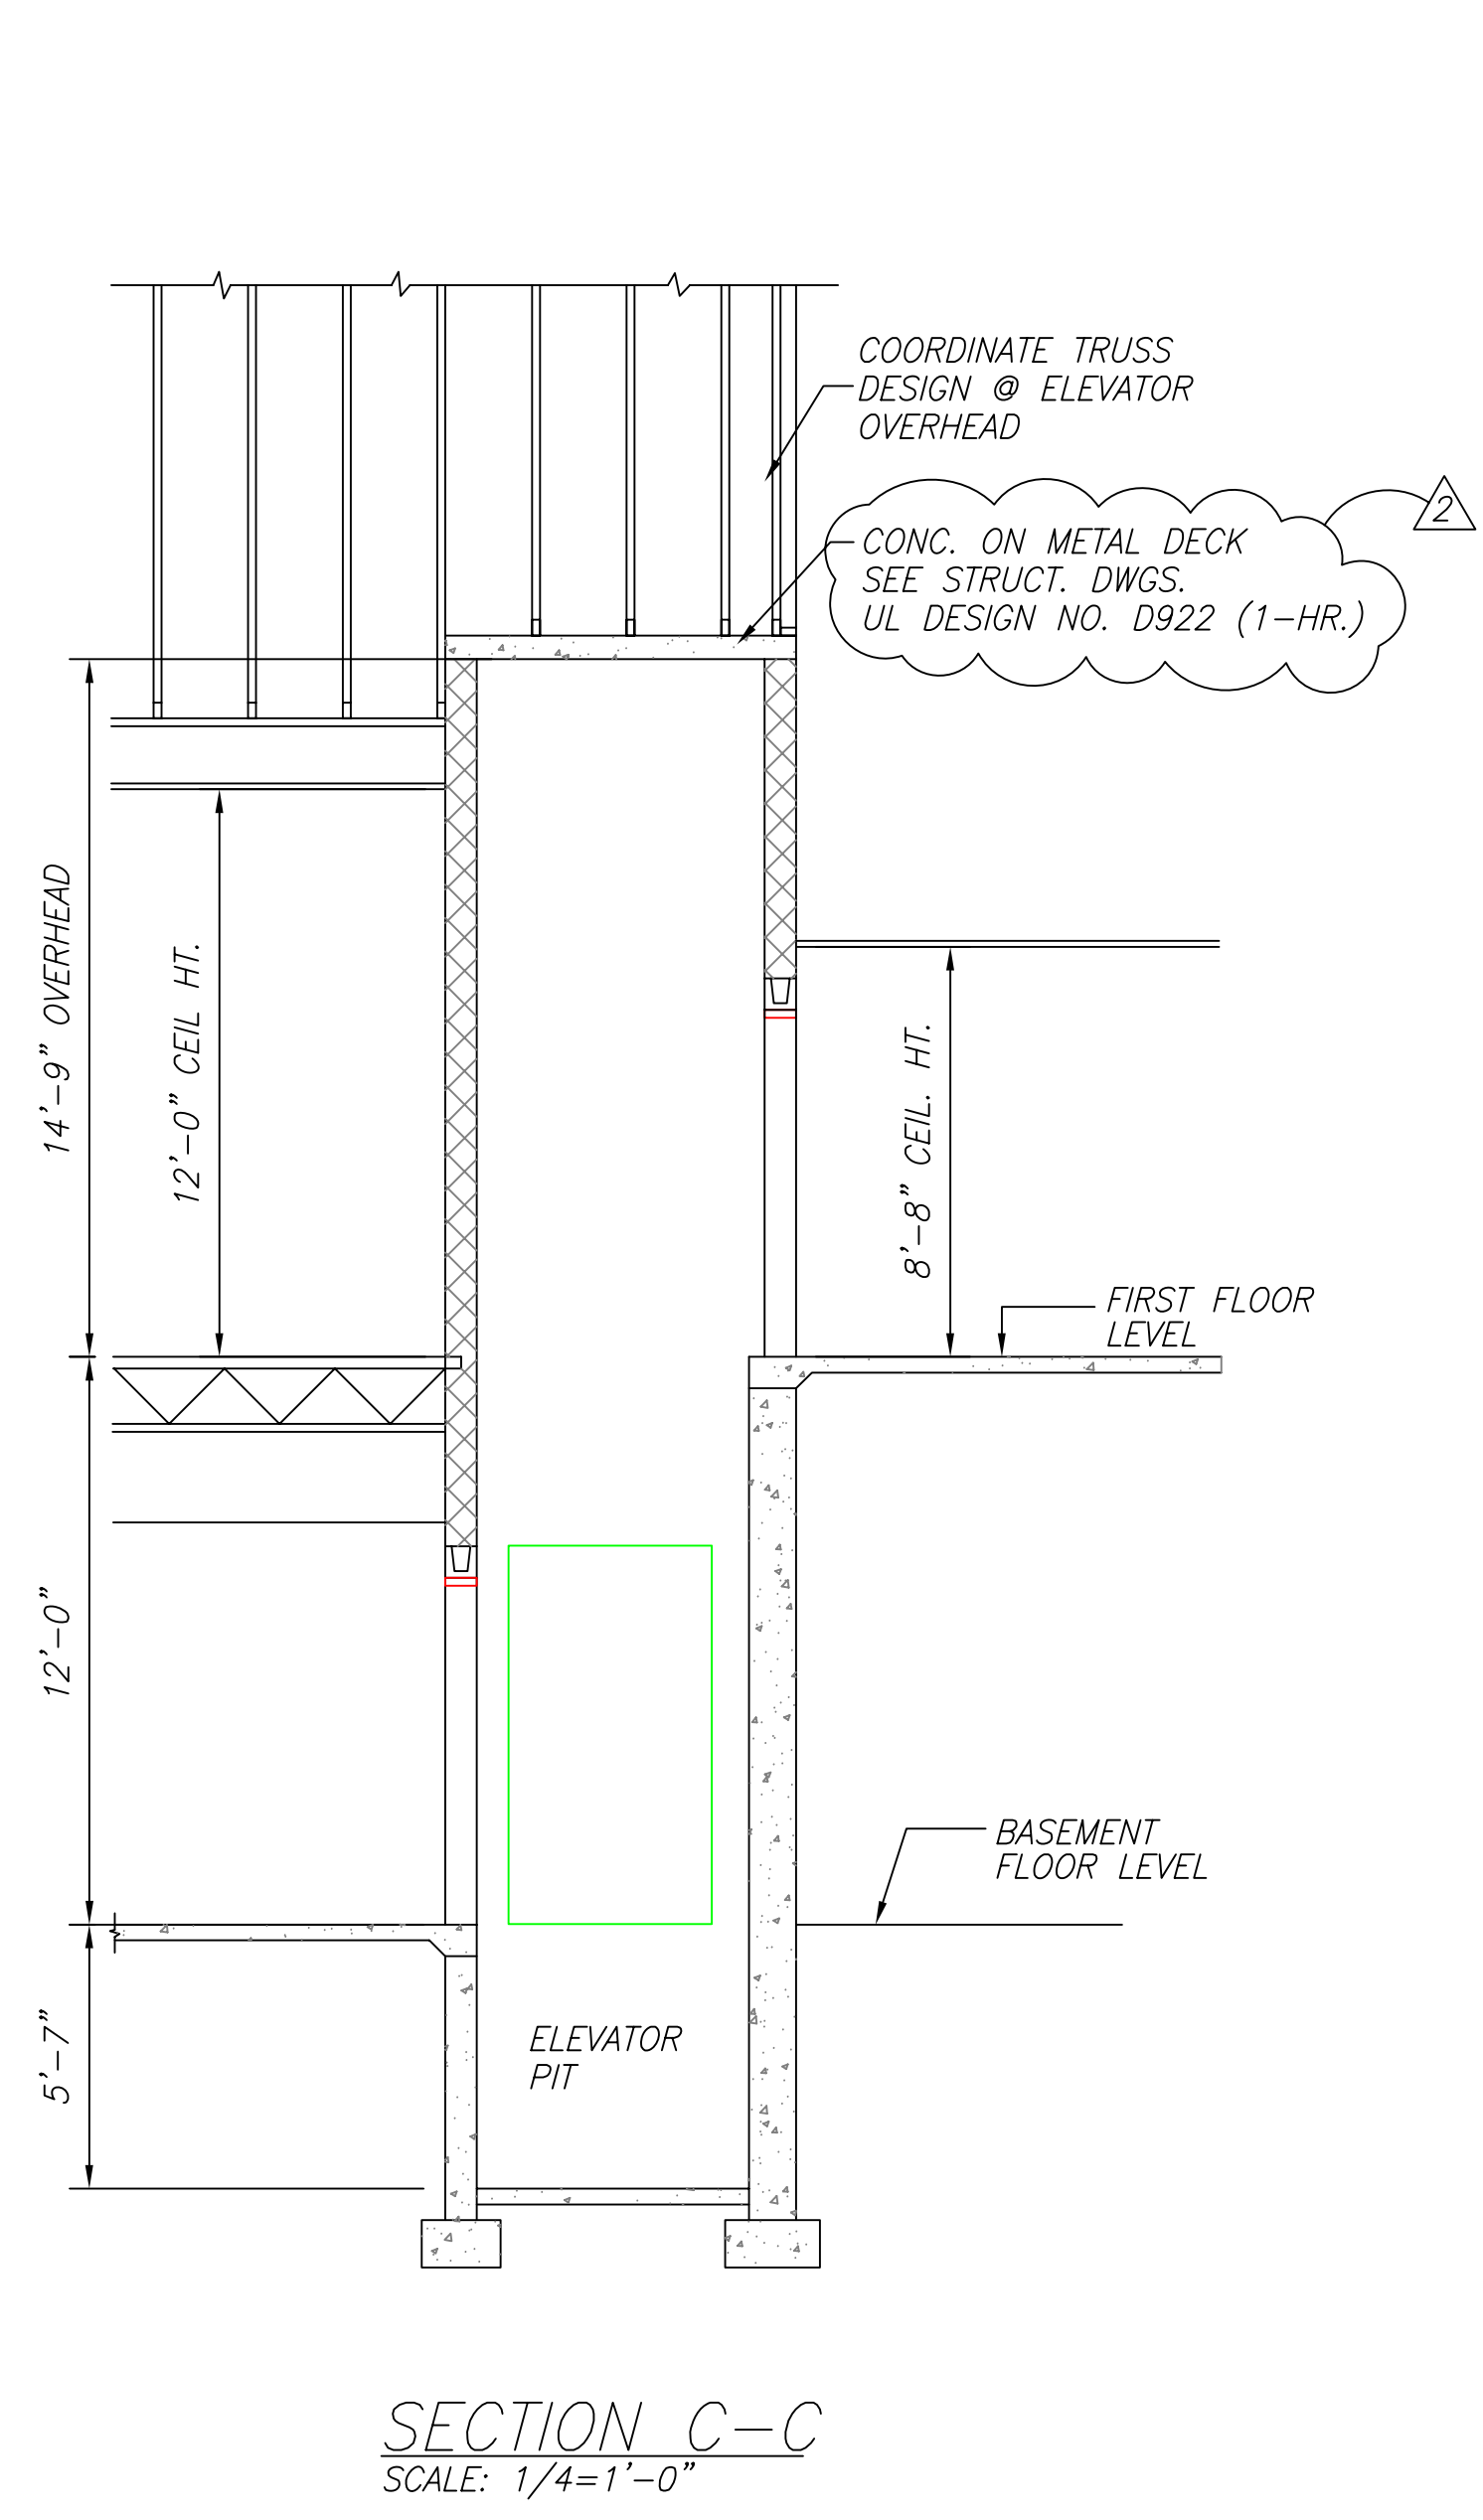


Copyright 2005 Philip Aaron Lesy, Architect. All rights reserved. No portion of this document may be reproduced without written permission.

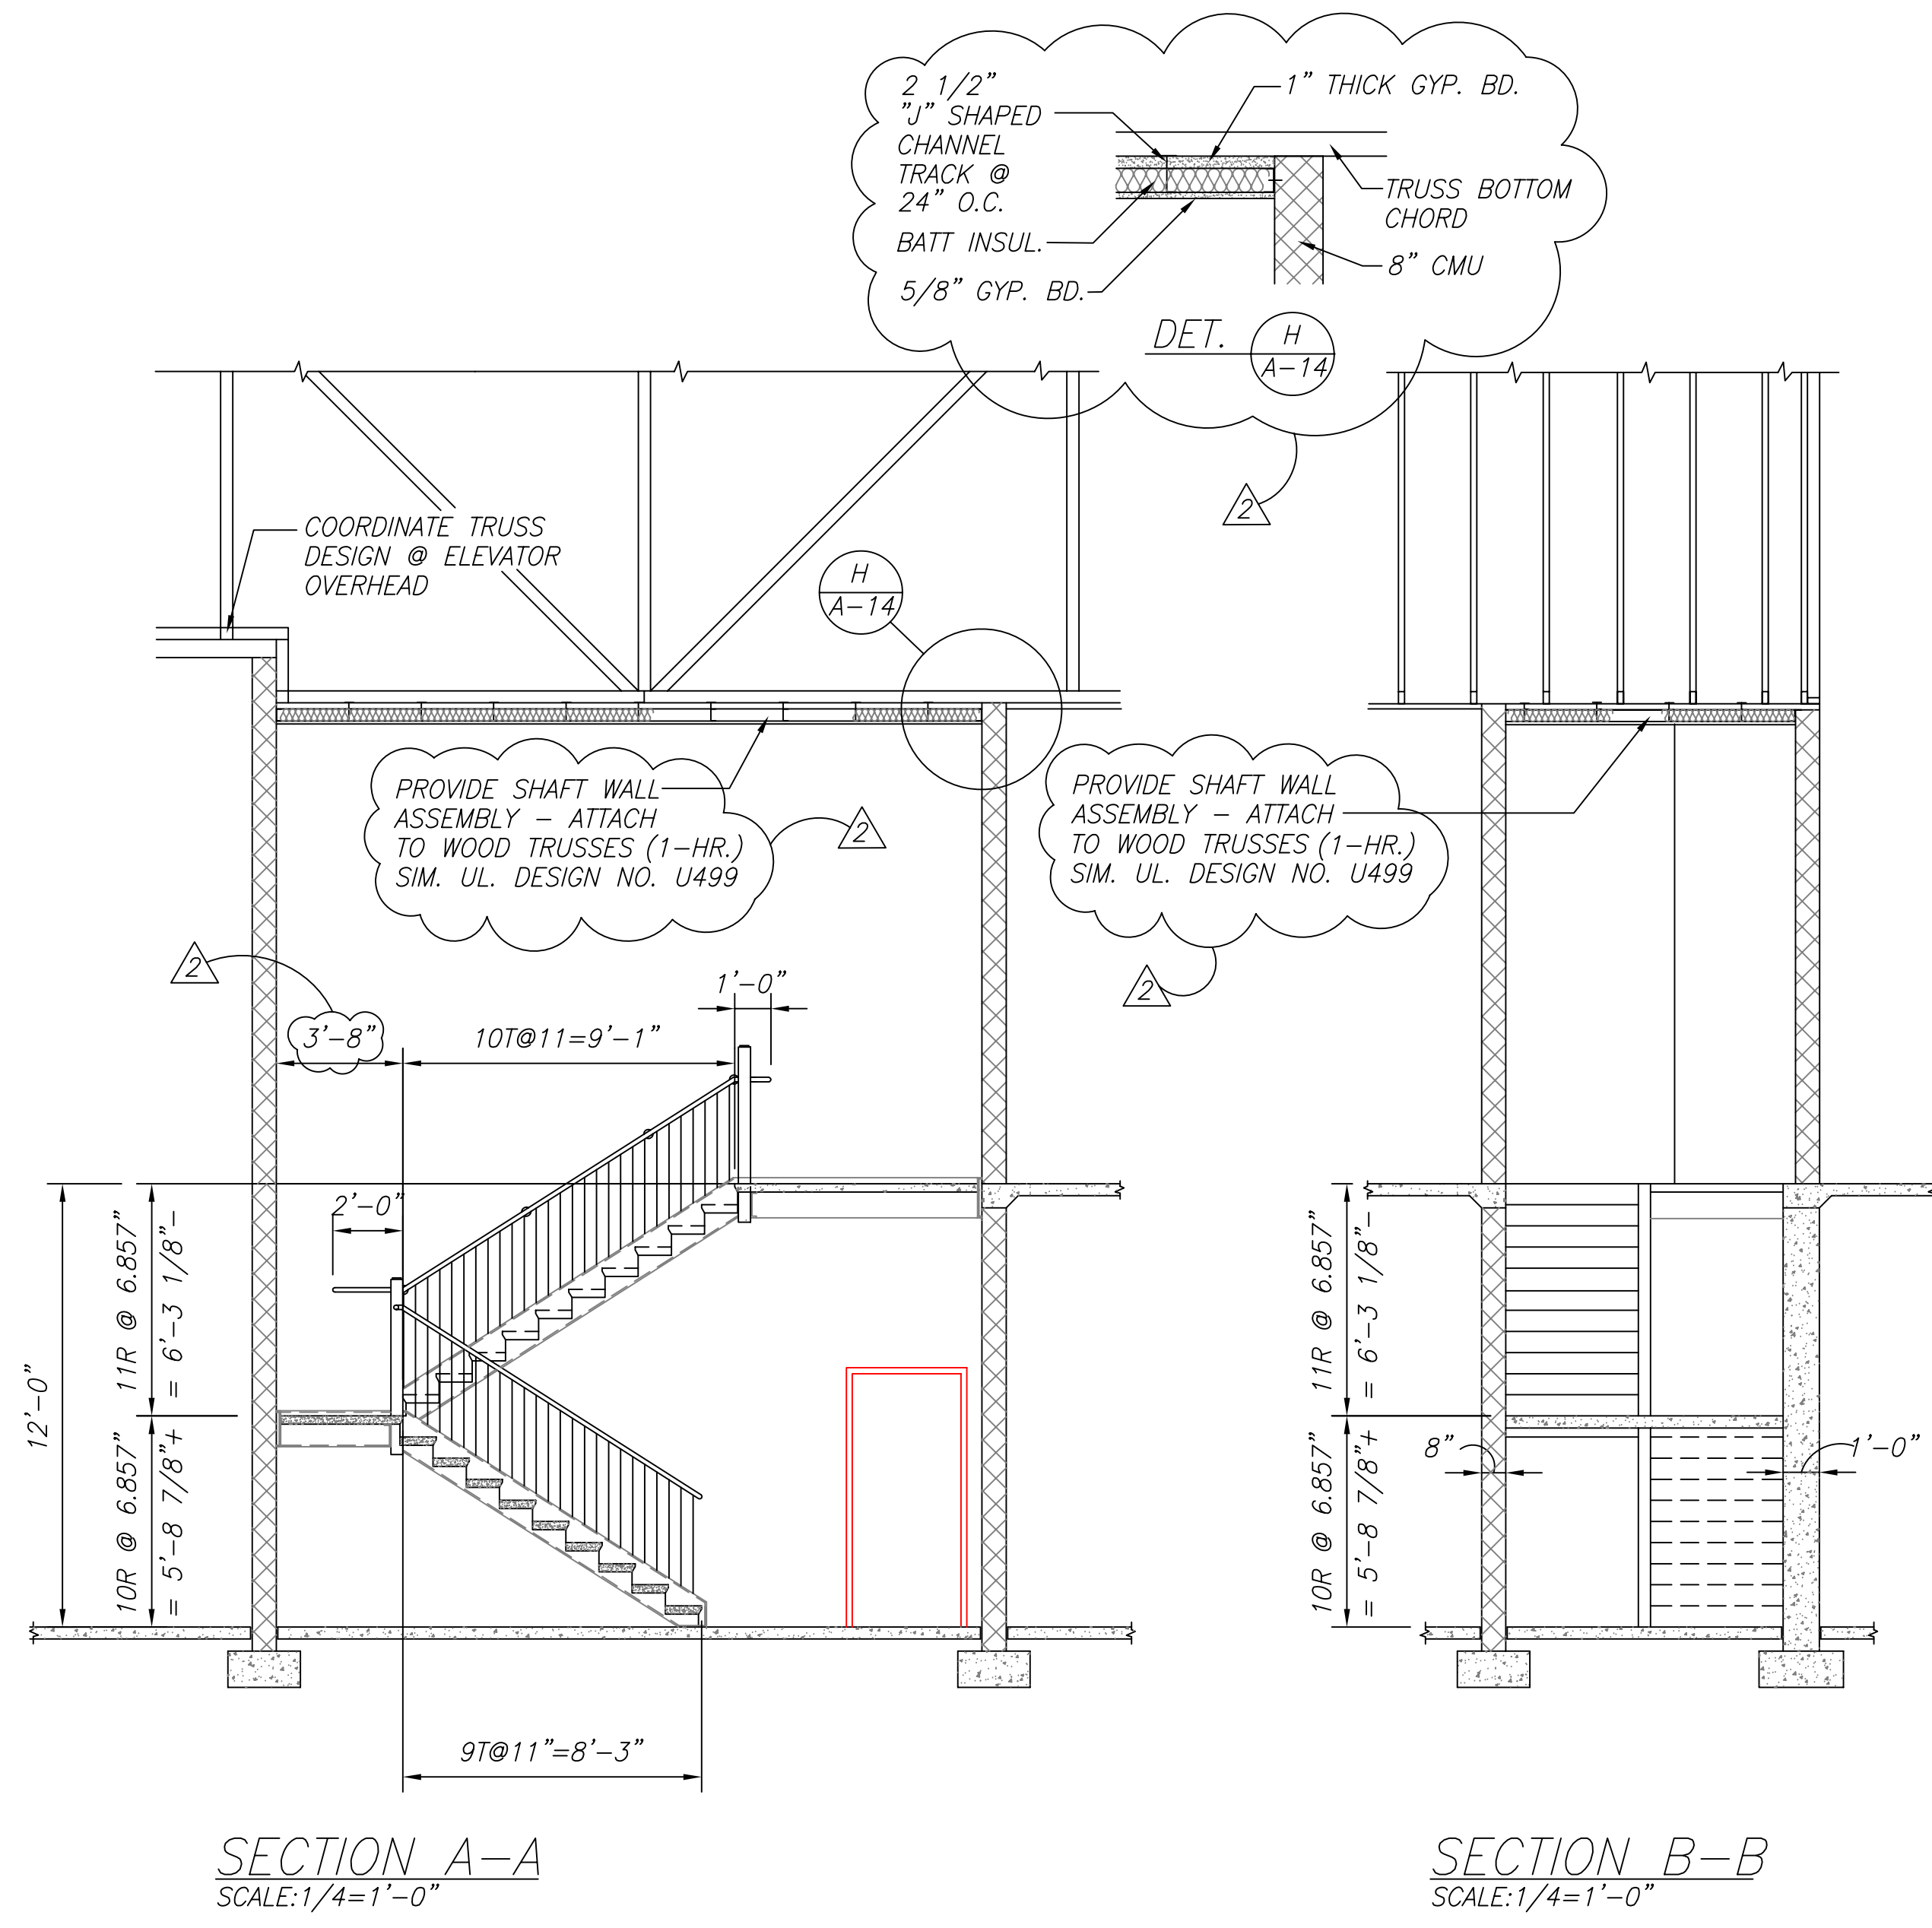

Date:	01-14-08
Revisions:	1 COUNTY REVIEW COMMENTS 01-14-08 2 COUNTY REVIEW COMMENTS 05-29-08
Consultants:	WARDER & ASSOCIATES, INC. CHURCH CONSTRUCTION SPECIALISTS 8016 OLD ALEXANDRIA FERRY ROAD CLINTON, MARYLAND 20735 Phone: 301-668-5900
Certification:	
Project Title:	BETH SHALOM A.M.E. ZION CHURCH 2501 RITCHIE ROAD DISTRICT HEIGHTS, MARYLAND 20735 STAIRWELL AND ELEVATOR DETAILS
Philip Aaron Lacy, Architect	6188 Oxon Hill Road, Suite 303 Oxon Hill, Maryland 20745 Phone: 301-567-8223
Date:	DEC. 1, 2005
Scale:	1/4"=1'-0"
Drawn:	FCB
Checked:	PAL
File No.	BETH_A14
Drawing No.	A-14
	of